



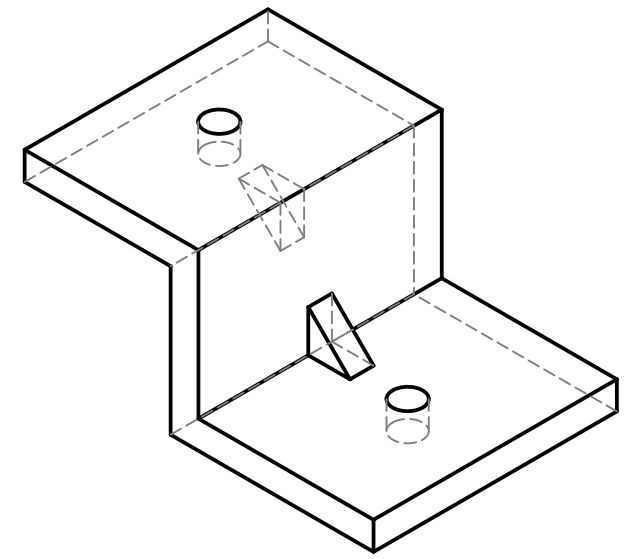

ISO VIEW (NTS)

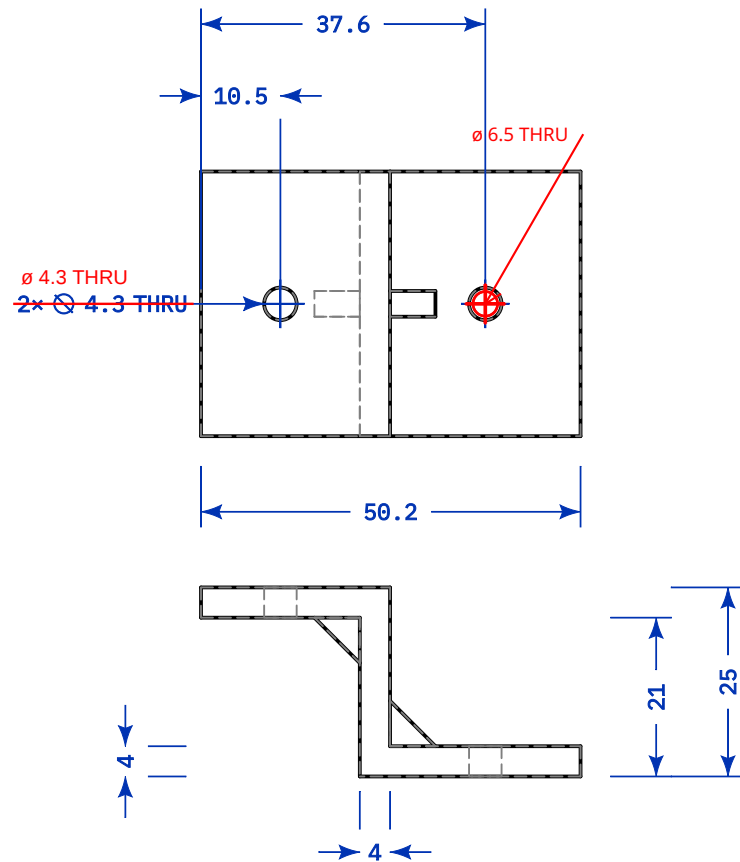

TITLE	Mounting Bracket	DWG NO.	RB-1042	SCALE	1:1	MAT.	6061-T6 Aluminum	REV	A B
GEN. TOL.	ISO 2768-m		DRAWN BY	draftwright					